




South Elevation

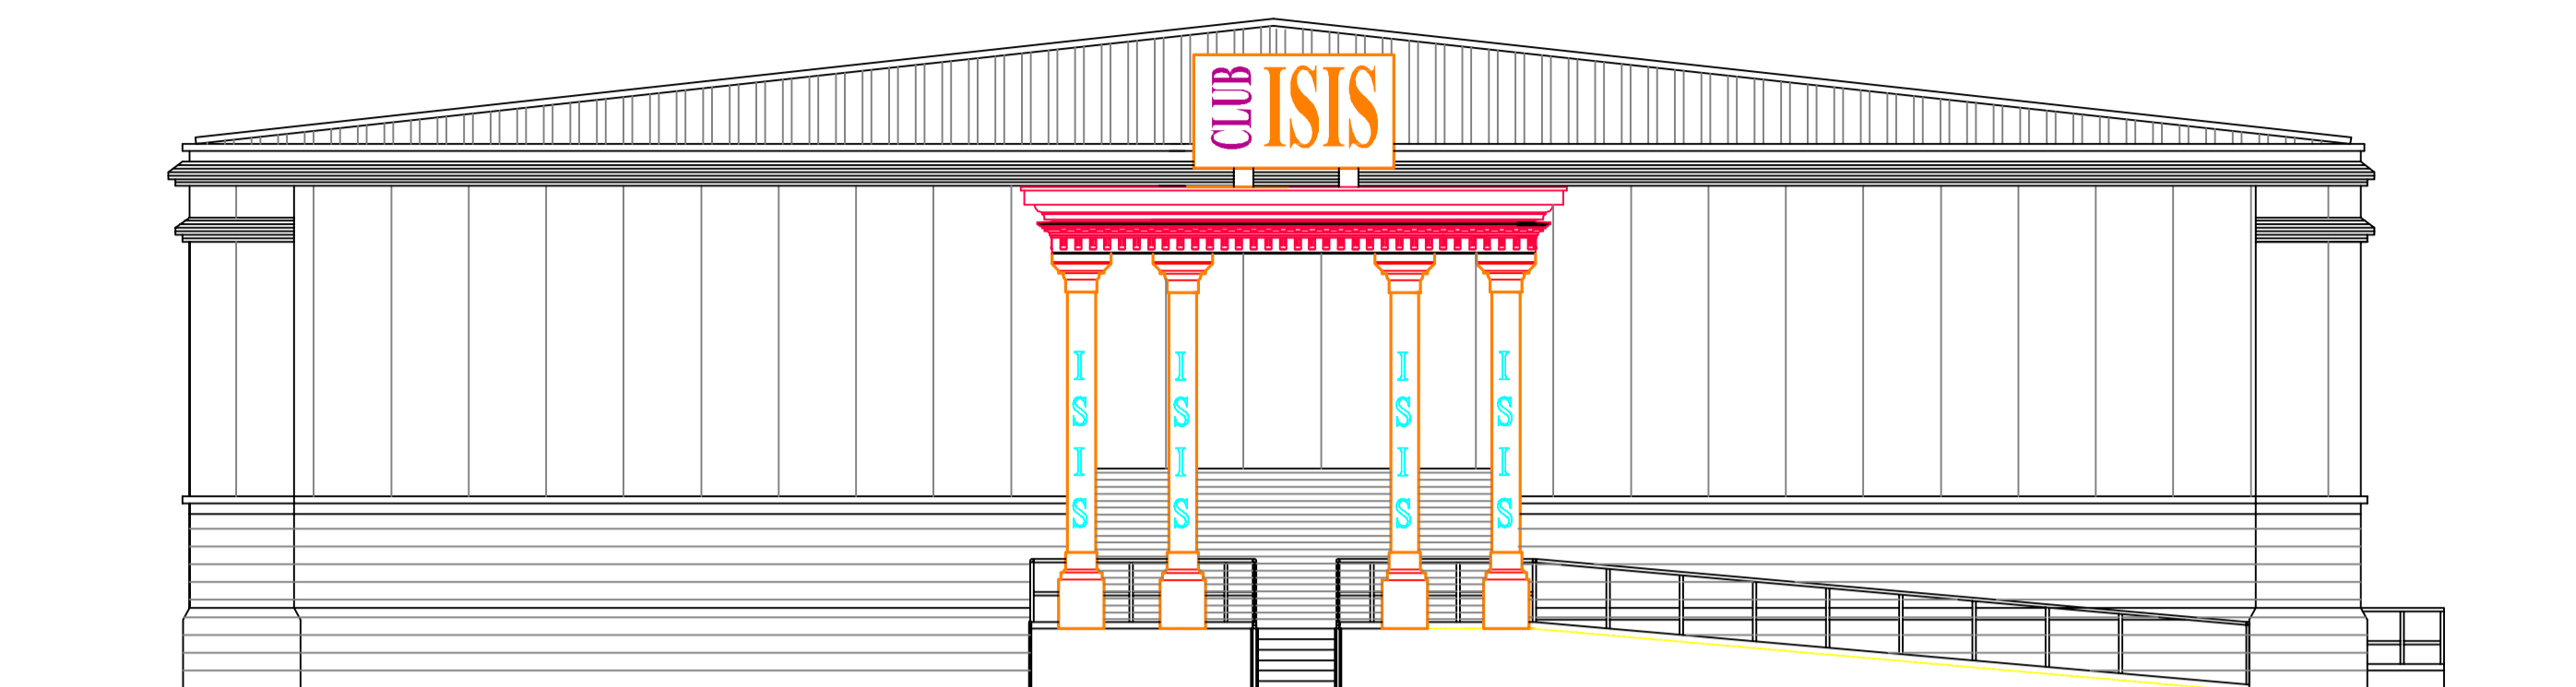

North Elevation

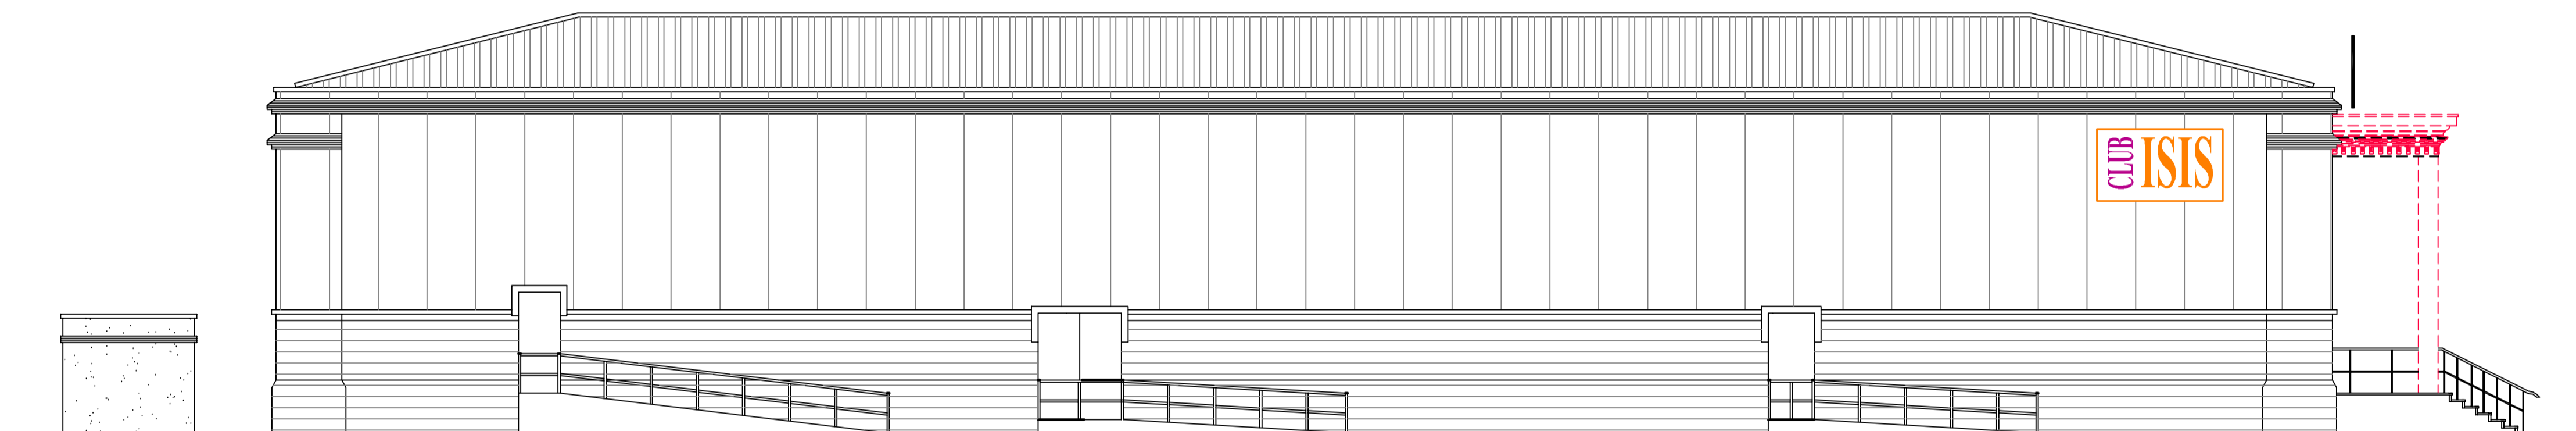

East Elevation

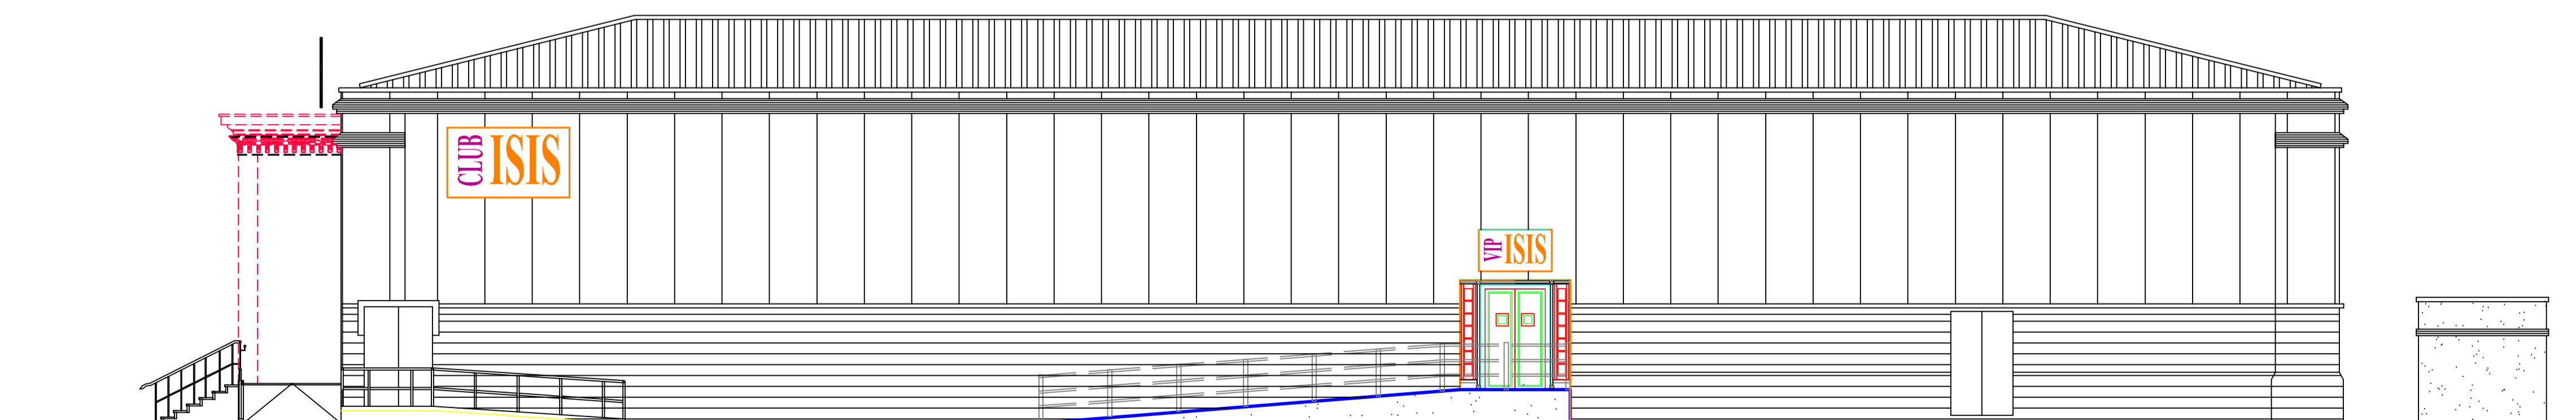

West Elevation

No.	Revision/Issue	Date
K	As Built Amendments	3/12/05

Thinking Leisure Limited  
 Site Location:  
 ISIS Leisure Complex  
 Stonedale Retail Park  
 Liverpool, L11 9BZ

Project:  
 Proposed Nightclub  
 Drawing Title:  
 Elevations

Project Number:  
 BPE/2004/19/10  
 Date: December, 05  
 Drawn by: PE/BA/MD  
 Scale: 1:100  
 Revision: K  
 Drawing Number: 003

**Paul Ennis ASSOCIATES** Limited  
 Consultant Building Surveyors & Engineers  
 The Grove, Belgrave Road, Birkdale, Southport, PR8 2DZ.  
 T: 01704 562 675 F: 01704 560 959  
 E: architecture@paulennis.co.uk