Paul Ennis Associates Limited

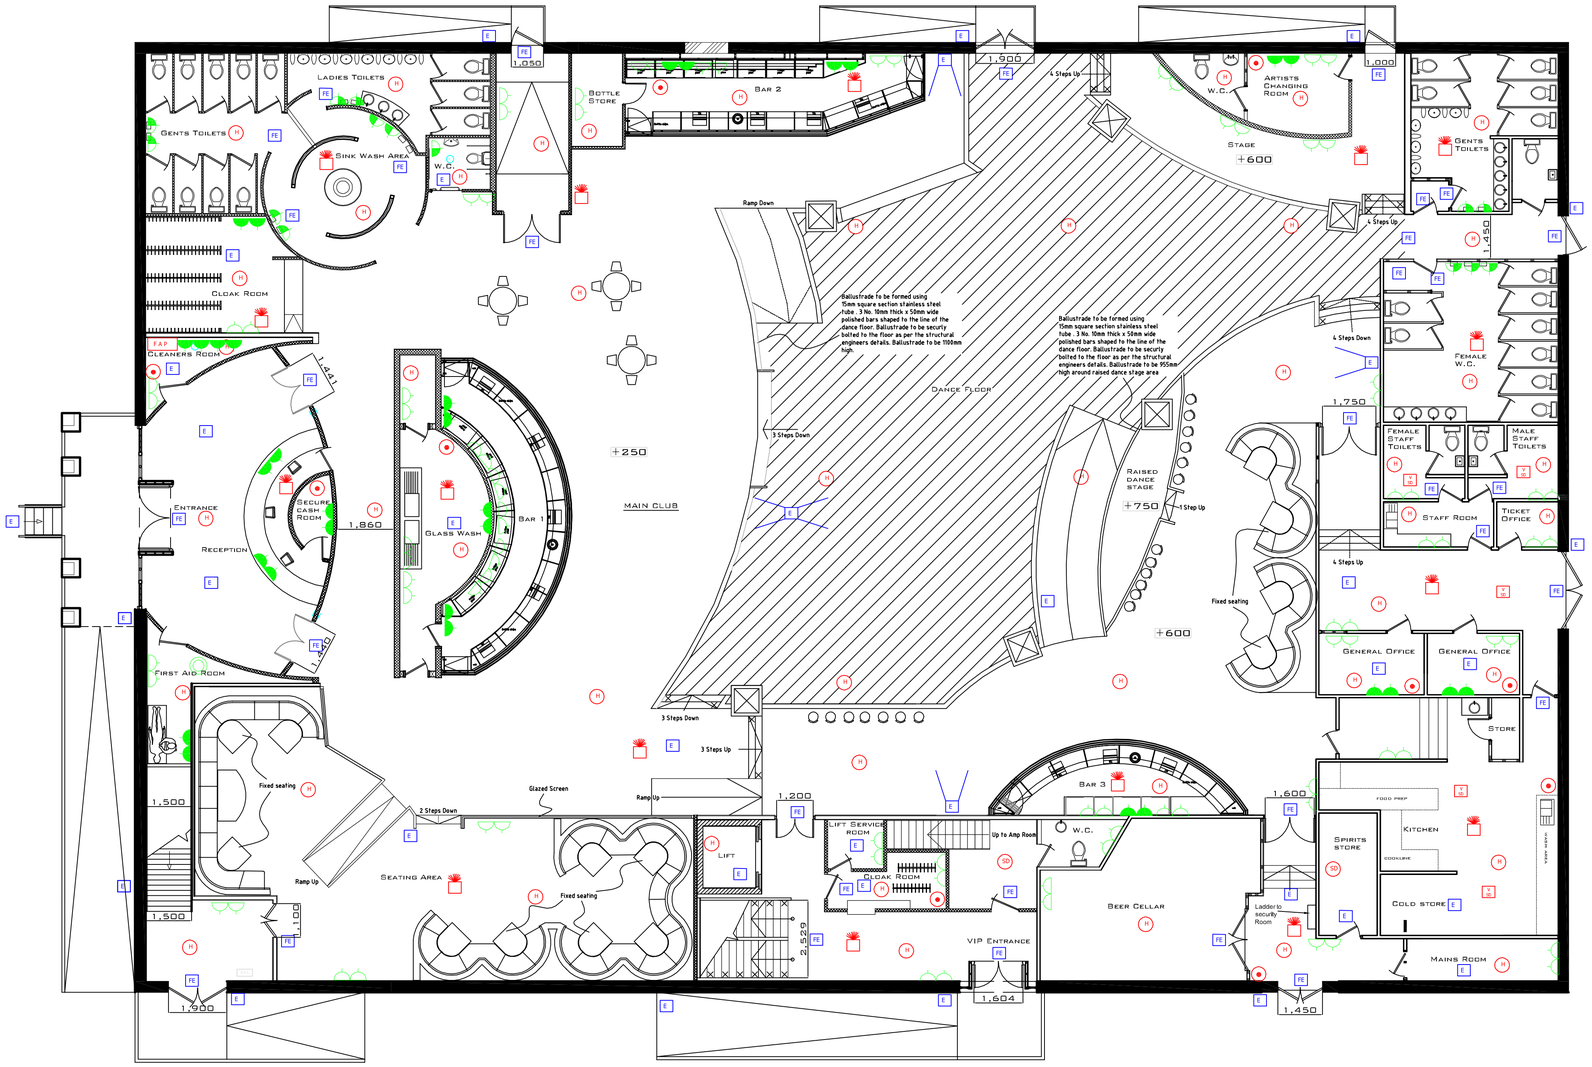

FIRE ALARM

- F A P — FIRE ALARM PANEL
- CC — CENTRE CONNECTION
- V SD — SMOKE DETECTOR (VOID FIXED)
- V RI — VOID REMOTE INDICATOR
- BREAK GLASS UNIT
- SOUNDERS INCLUDING XENON TYPE BEACONS
- H — HEAT DETECTOR (CEILING FIXED)
- SD — SMOKE DETECTOR (CEILING FIXED)
- EXTRACT FAN
- D — 2D x 1G WATT DRUM FITTING
- E — 1 x 8 WATT N/M EMERGENCY FITTING
- FE — 1 x 8 WATT MAINTAINED EMERGENCY FITTING
- E — HIGH OUTPUT EMERGENCY FLOODLIGHT WITH 4 X 900 LUMENS
- Double socket
- Fused Spur
- Double socket incorporating isolator switch

No.	Revision/Issue	Date
K	As Built Amendments	3/12/05

Thinking Leisure Limited

Site Location:
ISIS Leisure Complex
Stonedale Retail Park
Liverpool, L11 9BZ

Project:
Proposed Nightclub

Drawing Title:
Ground Floor Plan

Project Number: BPE/2004/19/10

Date:	Drawn by:	
December, 05	PE/BA/MD	
Scale: 1:100	Revision: K	Drawing Number: 001

Paul Ennis ASSOCIATES Limited
Consultant Building Surveyors & Engineers
The Grove, Belgrave Road, Birkdale, Southport. PR8 2DZ.
T: 01704 562 675 F: 01704 560 959
E: architecture@paulennis.co.uk